


GENERAL NOTES:

1. REFER TO BLOCK DIAGRAM FOR ADDITIONAL INFORMATION.
2. PROVIDE SUITABLY SIZED INNERDUCT FOR ALL FIBER OPTIC CABLES.



DRAWING NOTES

1. PROVIDE FIBER CABLE(S) FROM RELOCATED DATA RACK INSTALLED IN OFFICE E-1 OF ENERGY BLDG. TO THE CAMPUS COMPUTER CENTER IN CAREER BUILDING.
2. PROVIDE FIBER CABLE(S) FROM CHILD CARE/TECHNICAL BUILDING TO CAMPUS COMPUTER CENTER IN CAREER BUILDING.
3. PROVIDE FIBER CABLE(S) FROM TECHNICAL BUILDING TO CAMPUS COMPUTER CENTER IN CAREER BUILDING.
4. PROVIDE NEW 4" DIRECT BURIED PVC CONDUIT WITH (2) 1 1/4" AND (1) 1 1/2" INNER DUCTS FROM ENERGY BUILDING TO CHILD CARE/TECHNICAL BUILDING.
5. PROVIDE FIBER CABLE(S) FROM CLASSROOM BUILDING TO CAMPUS COMPUTER CENTER IN CAREER BUILDING.
6. REMOVE EXISTING AND PROVIDE NEW FIRE ALARM MANUAL PULL STATION.
7. RE-USE EXISTING FIRE ALARM CABLE FOR INITIATION TYPE DEVICES. CONNECT TO NEW FACP PER MANUFACTURER'S RECOMMENDATIONS.
8. REMOVE EXISTING AND PROVIDE NEW IONIZATION SMOKE DETECTOR OR HEAT DETECTOR AS INDICATED.
9. INTERFACE EX. FACP WITH NEW FACP.
10. PROVIDE NEW SMOKE DETECTOR ABOVE NEW FACP.
11. PROVIDE SINGLE POLE, 20 AMPERE CIRCUIT BREAKER IN SPACE 15 OF EXISTING PANELBOARD "EX" AS INDICATED. CIRCUIT BREAKER TYPE SHALL MATCH EXISTING. EXISTING PANELBOARD IS BY FPE, TYPE NBLP.
12. PROVIDE SINGLE POLE, 20 AMPERE CIRCUIT BREAKERS IN SPACES 22 AND 24 OF EXISTING PANELBOARD "BL" AS INDICATED. CIRCUIT BREAKER TYPE SHALL MATCH EXISTING. EXISTING PANELBOARD IS BY FPE, TYPE NBLP.
13. CONNECT CIRCUIT TO SPARE CIRCUIT BREAKER IN PANELBOARD AS INDICATED. RUN 2 #12 AND 1 #12 GROUND IN 3/4" CONDUIT FOR EACH CIRCUIT.
14. PROVIDE FIBER OPTIC CABLE IN INNERDUCT FROM NEW FACP TO RESPECTIVE DATA CABINET.
15. REMOVE EXISTING ANNUNCIATION DEVICE AND PROVIDE NEW ANNUNCIATION DEVICE IN PLACE OF EXISTING. EXISTING ANNUNCIATION DEVICE SHALL BE REPLACED IN KIND. PROVIDE NEW CONCEALED FIRE ALARM CABLE (TYPE FPLP/MC) IN RED STEEL ARMOR JACKET FROM NEW DEVICE TO NEW FACP.
16. PROVIDE CATEGORY 3 TELEPHONE CABLE FOR FIRE ALARM AUTODIALER FROM NEW FACP TO RESPECTIVE TELEPHONE TERMINAL BOARD/CABINET (TTB/TTC). TERMINATE FOR TWO TELEPHONE LINES.

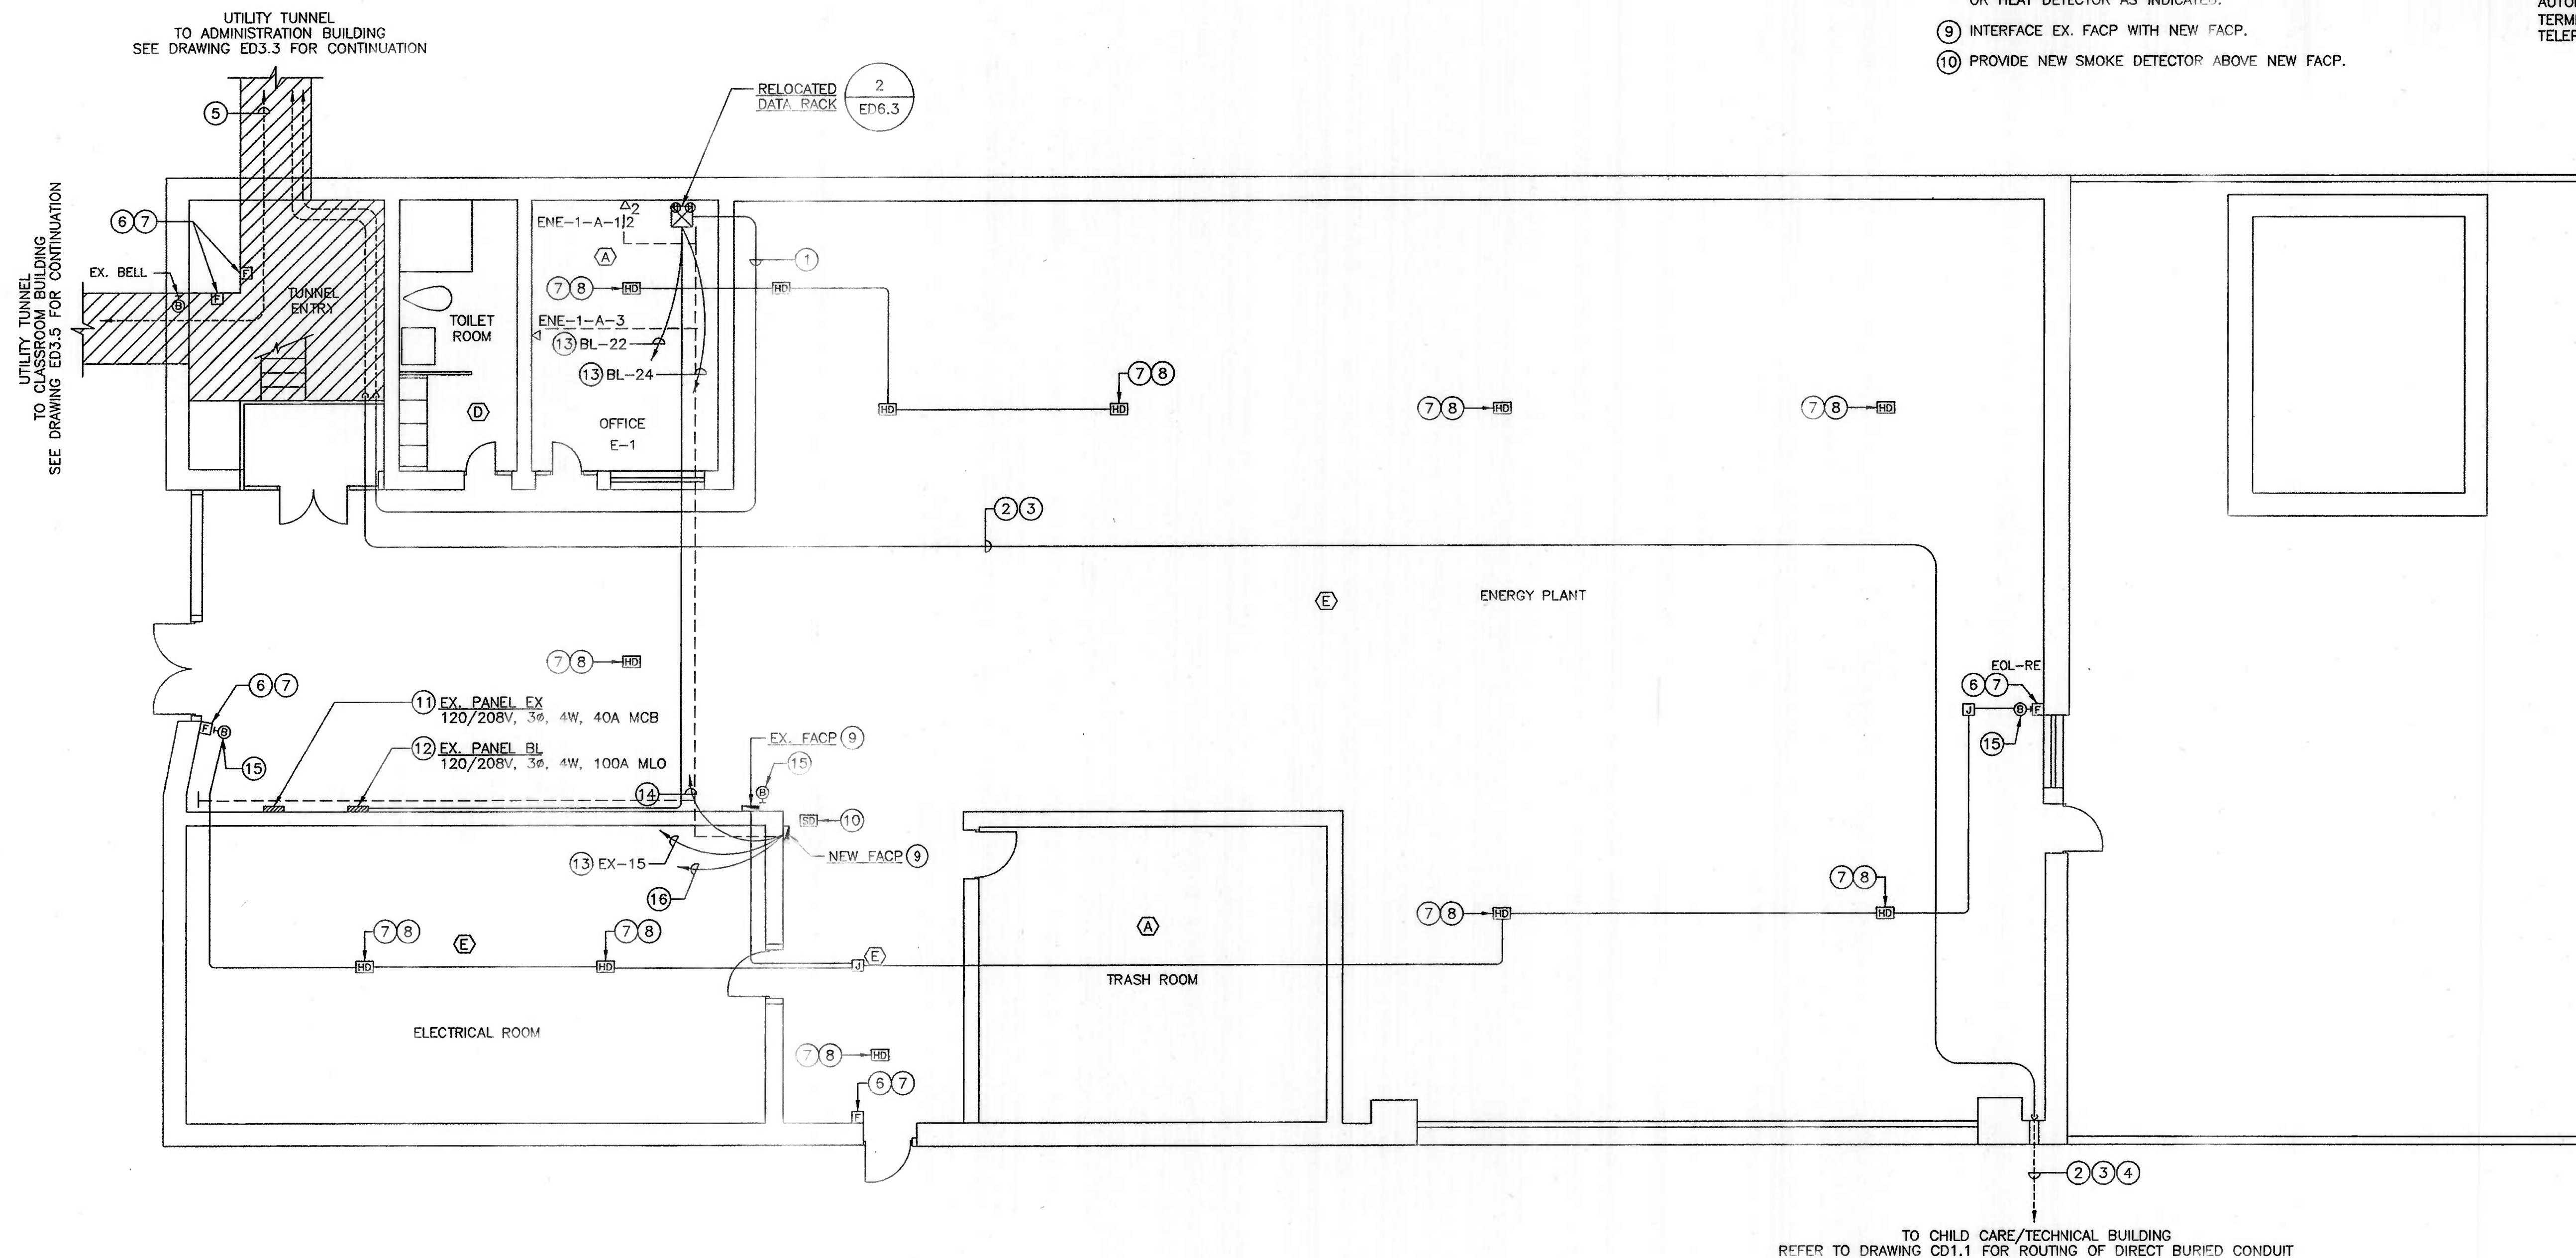


ENERGY PLANT - FLOOR PLAN

SCALE: 1/8" = 1'-0"

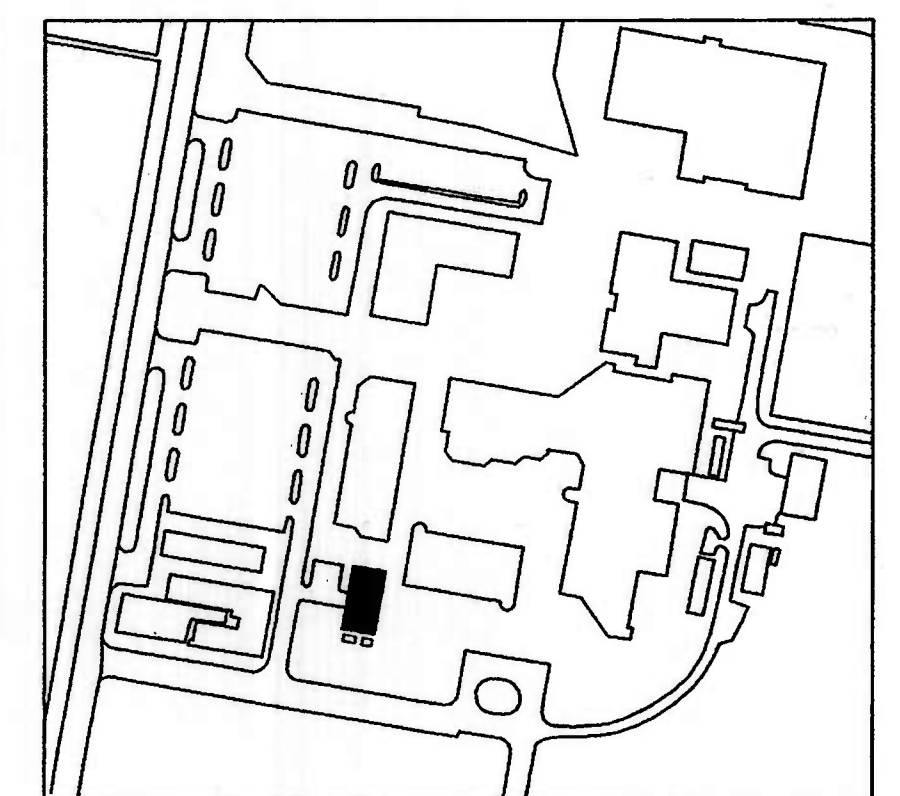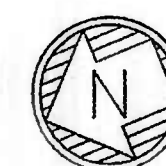

KEY PLAN
NOT TO SCALE

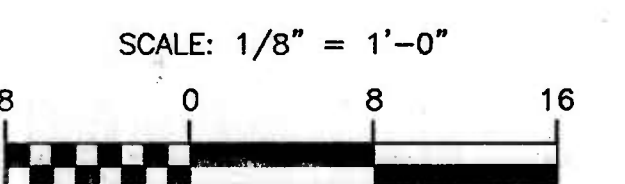

RELEASED FOR


- ☐ PRELIMINARY ONLY
- ☐ BIDDING
- ☐ PERMIT
- ☐ CONSTRUCTION
- ☒ AS-BUILT RELEASE

DATE: 10/3/2001

"THIS DRAWING AND THE DESIGN AND CONSTRUCTION FEATURES DISCLOSED ARE PROPRIETARY TO GIPE ASSOCIATES, INC. AND SHALL NOT BE ALTERED OR REUSED IN WHOLE OR IN PART WITHOUT THE EXPRESS WRITTEN PERMISSION OF GIPE ASSOCIATES, INC. Copyright ©2000"



220 8th AVENUE, NW
GLEN BURNIE, MD 21061
410-412-2000

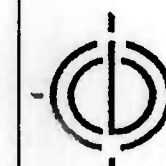

CCBC
The Community College
of Baltimore County

THE COMMUNITY
COLLEGE OF
BALTIMORE COUNTY
TELECOMMUNICATIONS/
INFRASTRUCTURE
PHASE I

Project 99043	Date 10/22/2002
Drawn by JTE	Checked by DAV
Revisions	
Date	Item

CCBC DUNDALK
BUILDING
FLOOR PLAN

Drawing Number
ED3.17

JWW 99043ED317.DWG

D-023110